

LANE EPP 35478

CIVIC ADDRESS: 1876 HUCKLEBERRY ROAD, KELOWNA

made by the  
Okanagan Co  
building  
the

These design and plan check  
accepted for a building permit  
permit and inspections  
District of Columbia  
from  
compliance. With the

Regional Development  
to relieve an over-  
crowded area.  
Constructing it in  
accordance with  
the laws.

Respectfully,  
not religious  
and constructive  
appropriate bylaws.

and appropriate

9.4.1  
1.42.3.05  
L.02 1.42.3.05

PLAN  
176.020  
H

UCKI

FILED

BER 110.0

630

Detail Scale 1:500


3

0.56

EASEMENT PLAN

B  
UT · EPP35479

8

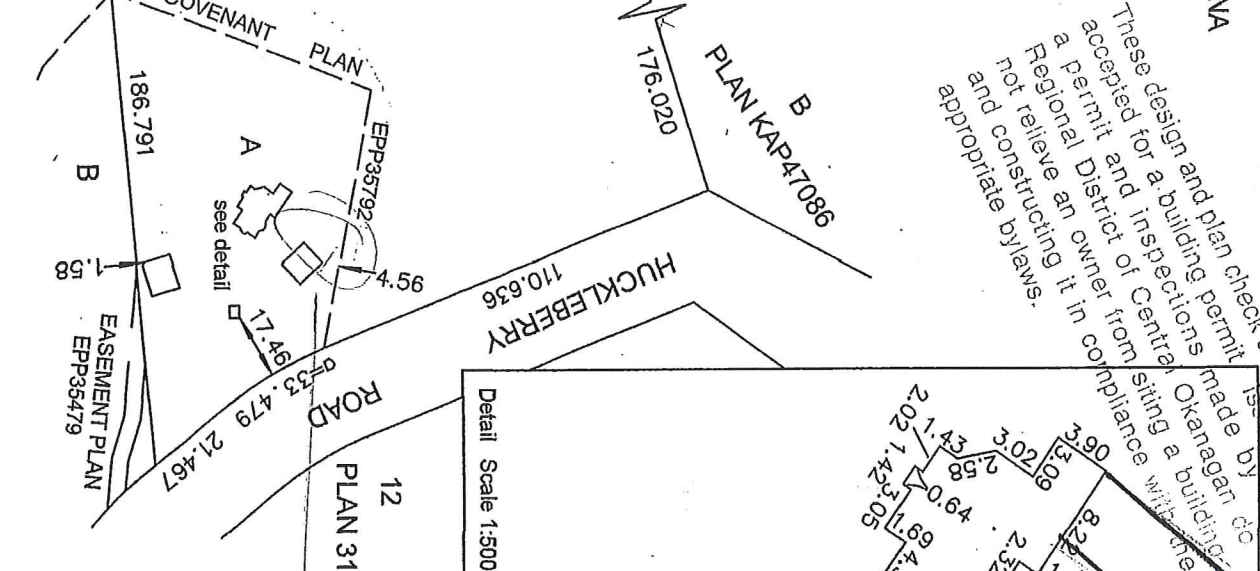

~~Certified correct~~ this 28th day of June, 2019.

British Columbia Land Surveyor

**This document is not valid unless originally signed and sealed.**