BRITISH COLUMBIA LAND SURVEYOR'S CERTIFICATE OF LOCATION OF BUILDINGS ON LOT A, SECTION 14, TOWNSHIP 27, ODYD, PLAN EPP35478.

PID: 029-245-389
CIVIC ADDRESS: 1876 HUCKLEBERRY ROAD, KELOWNA
CLIENT: NATALIE DRAY

This document shows the relative location of improvement(s) named above with respect to the boundaries of the described parcel.

This document was prepared for the exclusive use of the client named herein, for building permit purposes.

Lot dimensions shown are derived from Land Title Office records.

This document shall not be used to define property lines or corners.

AllTerra Land Surveying Ltd. and the signatory accept no responsibility for, and hereby disclaim all obligations and liabilities for:
- any damages arising out of any direct or indirect use or reliance upon this document beyond its intended use,
- any damages suffered by a third party as a result of actions taken or decisions made based upon this document.

All rights reserved. No person may copy, reproduce, transmit or alter this document in whole or in part, without the express written consent of AllTerra Land Surveying Ltd.

Scale 1:2000 Metric.
Distances shown are in metres and decimals thereof.

Notes:
- Unregistered interests have not been included or considered.

Charges on Title:
-Covenant CA3556237 (PLAN EPP35792)
-Statutory Right-of-Way CA4215027

These design and plan check corrections are accepted for a building permit. Issuance of a permit and inspections made by the Regional District of Central Okanagan do not relieve an owner from siting a building and constructing it in compliance with the appropriate bylaws.

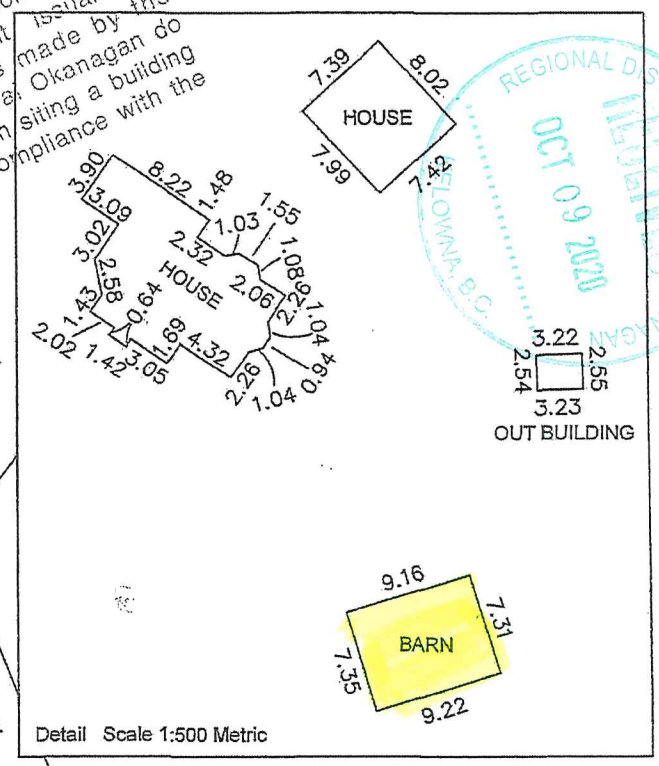

REGIONAL DISTRICT OF CENTRAL OKANAGAN
RECEIVED
OCT 09 2020
KELOWNA, B.C.

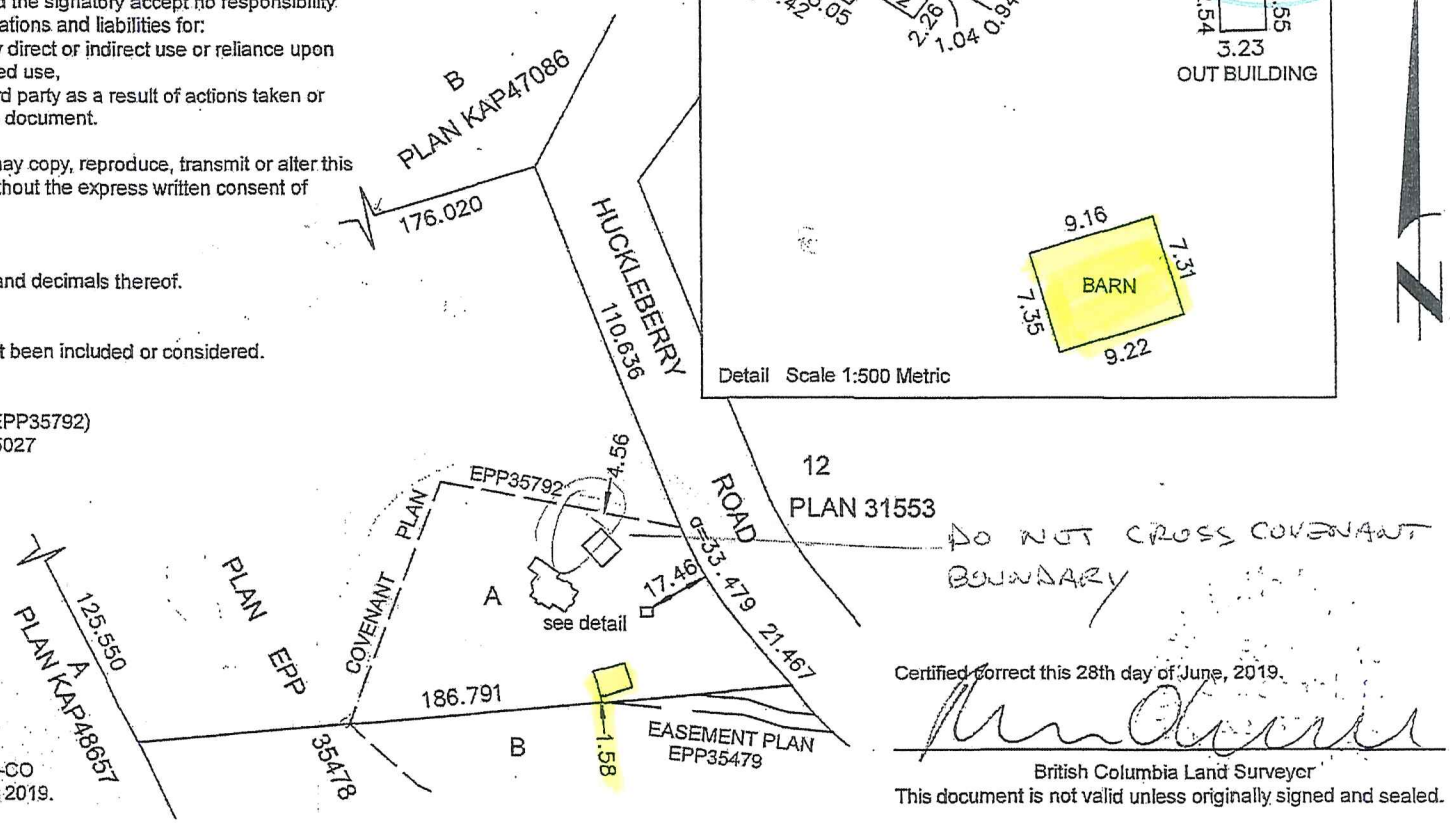

Certified correct this 28th day of June, 2019.

British Columbia Land Surveyor
This document is not valid unless originally signed and sealed.

AllTerra
Land Surveying Ltd.
www.AllTerraSurvey.ca
Ph: 250.762.0122 File: 319062-CO
© AllTerra Land Surveying Ltd. 2019.